



DO NOT SCALE THIS DRAWING
 THIS DRAWING IS TO BE READ IN CONJUNCTION WITH ALL OTHER RELEVANT ARCHITECTS AND STRUCTURAL ENGINEERS DRAWINGS
 ALL DIMENSIONS TO BE CHECKED ON SITE PRIOR TO COMMENCEMENT OF WORKS AND ANY DISCREPANCIES ARE TO BE REPORTED TO THE ARCHITECT.

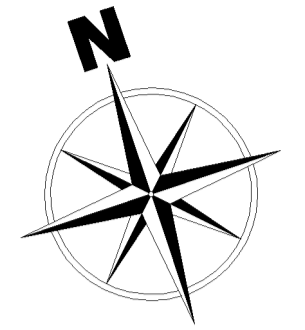

NIA :- 917.2sqm / 9,872sqft
 IPMS :- 930.8sqm / 10,019sqft
 Reception NIA :- 88.5sqm / 952.6sqft
 (Inc. Teapoint, exc. WC)

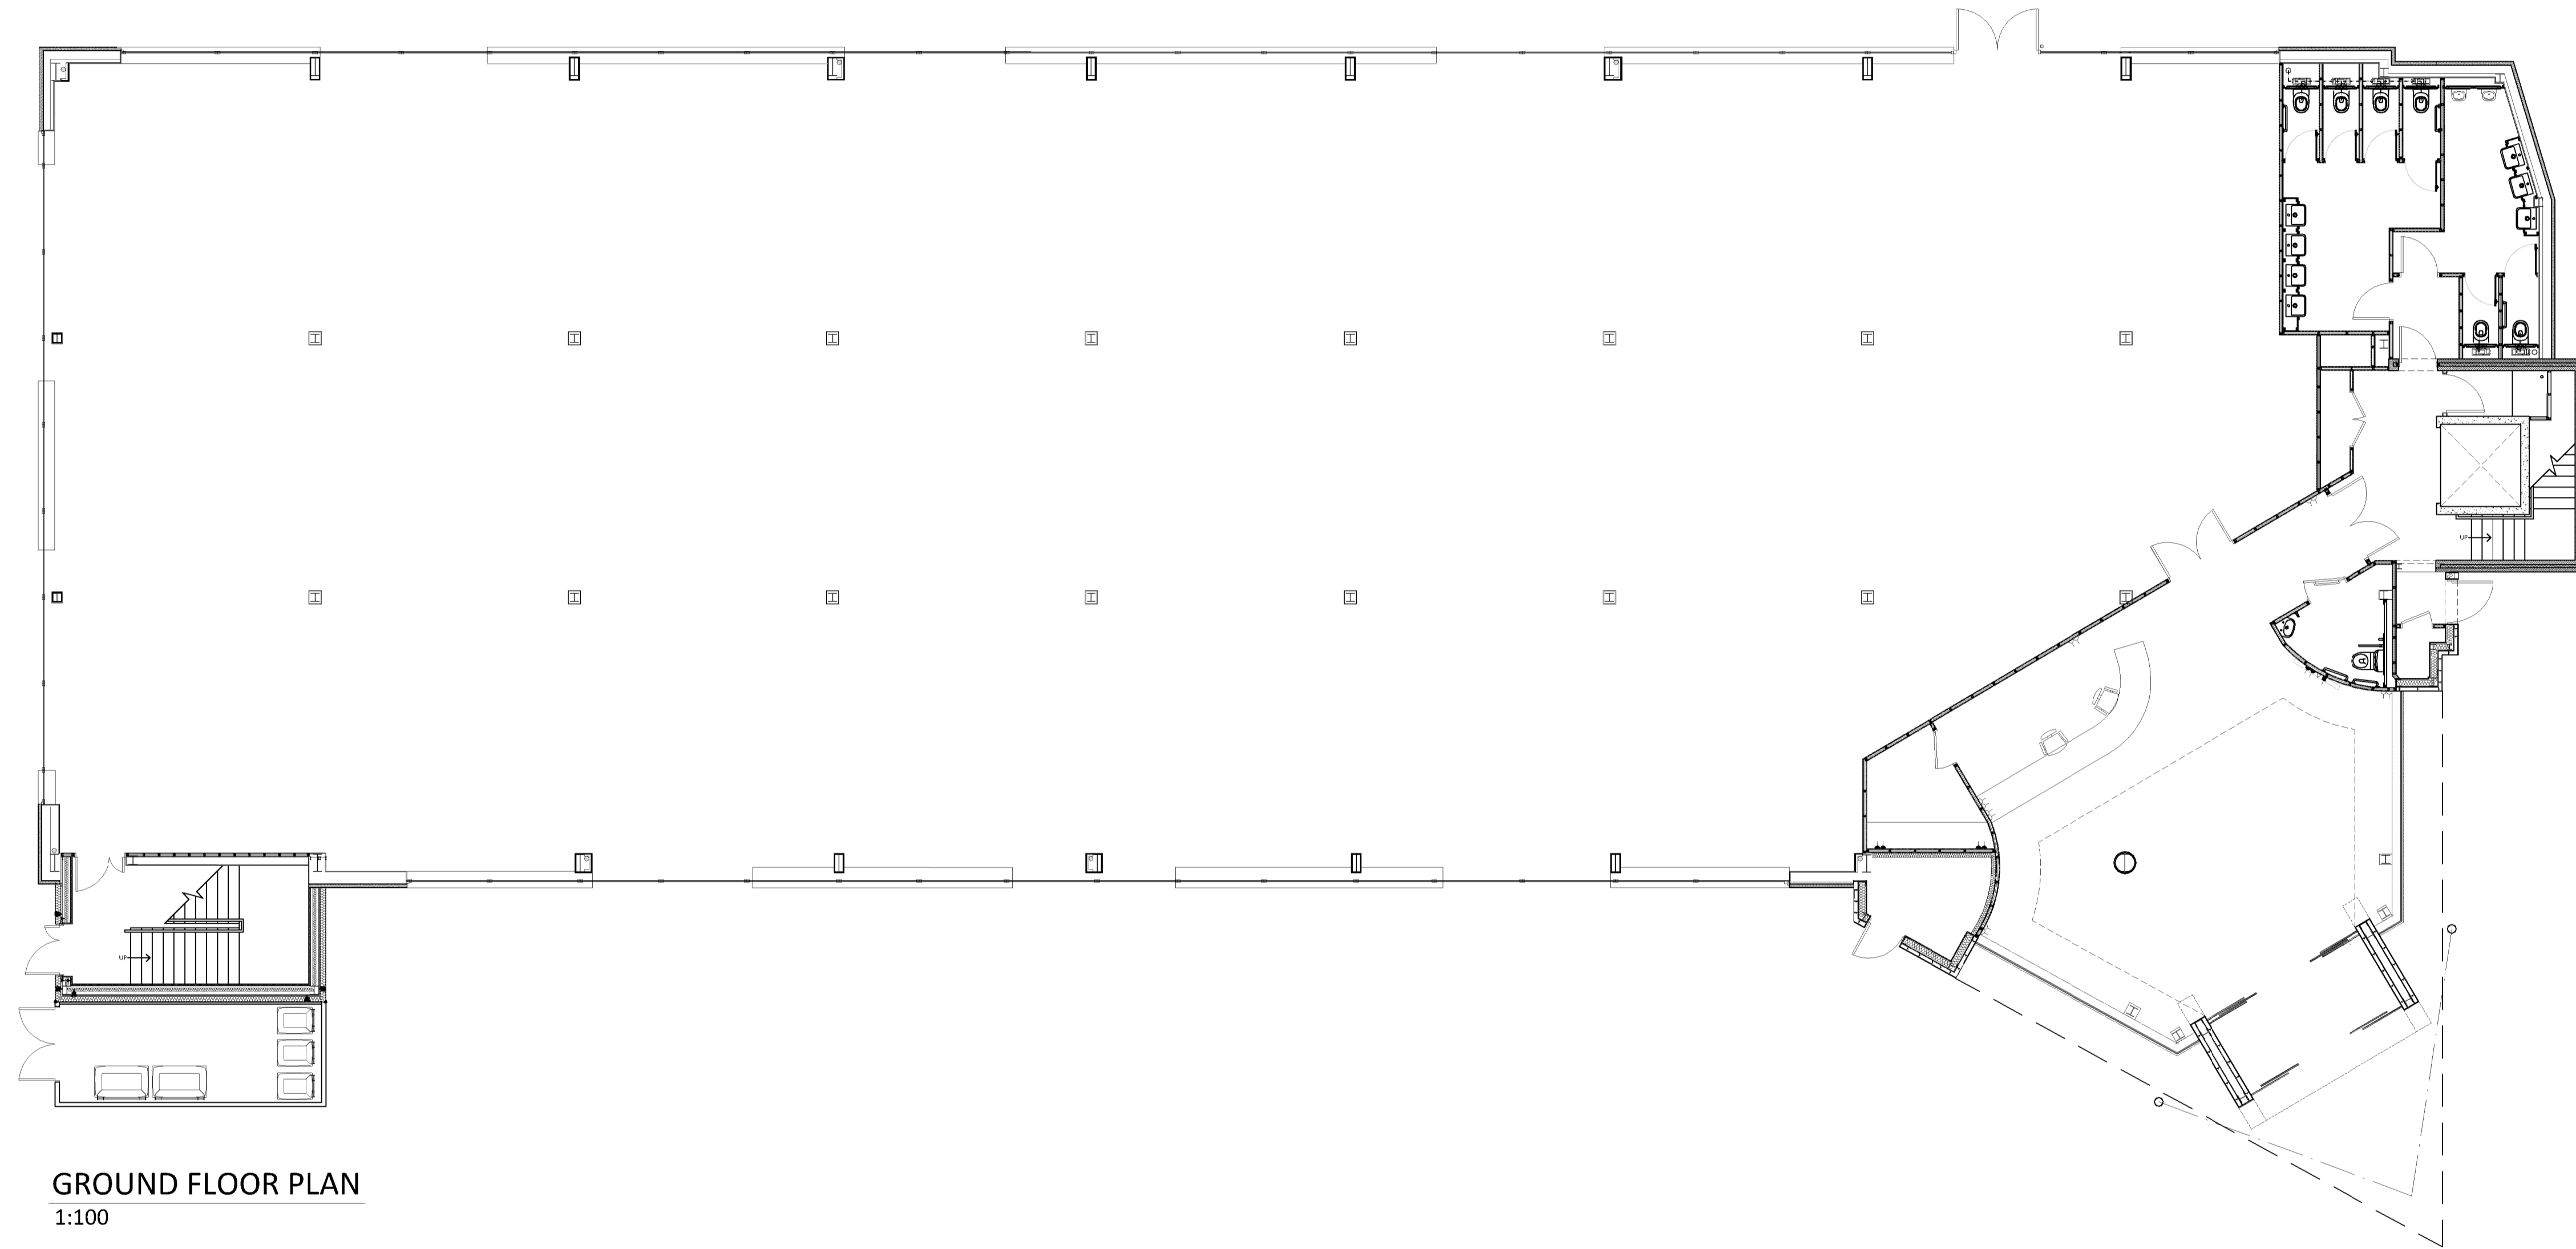

GROUND FLOOR PLAN
 1:100



REVISIONS	DATE	INITIAL
PURPOSE OF ISSUE: --		


AS BUILT

CLIENT
MAVEN CAPITAL LTD.

PROJECT
 AURORA,
 VANWELL BUSINESS PARK,
 MAIDENHEAD

SUBJECT
 GROUND FLOOR PLAN

DATE	DRAWN
MAY 2017	AH
SCALE	CHECKED
1:100 @ A1	
DRAWING NO.	REV.
3317_AB01	A

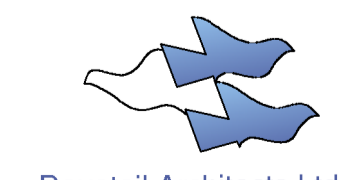

Dovetail Architects Ltd
 SUITE 4, CLOCKTOWER HOUSE
 HORNDRON INDUSTRIAL PARK
 WEST HORNDRON, ESSEX, CM13 3XL
 TEL: (01708) 225547